PROPOSED 20' WIDE EASEMENT

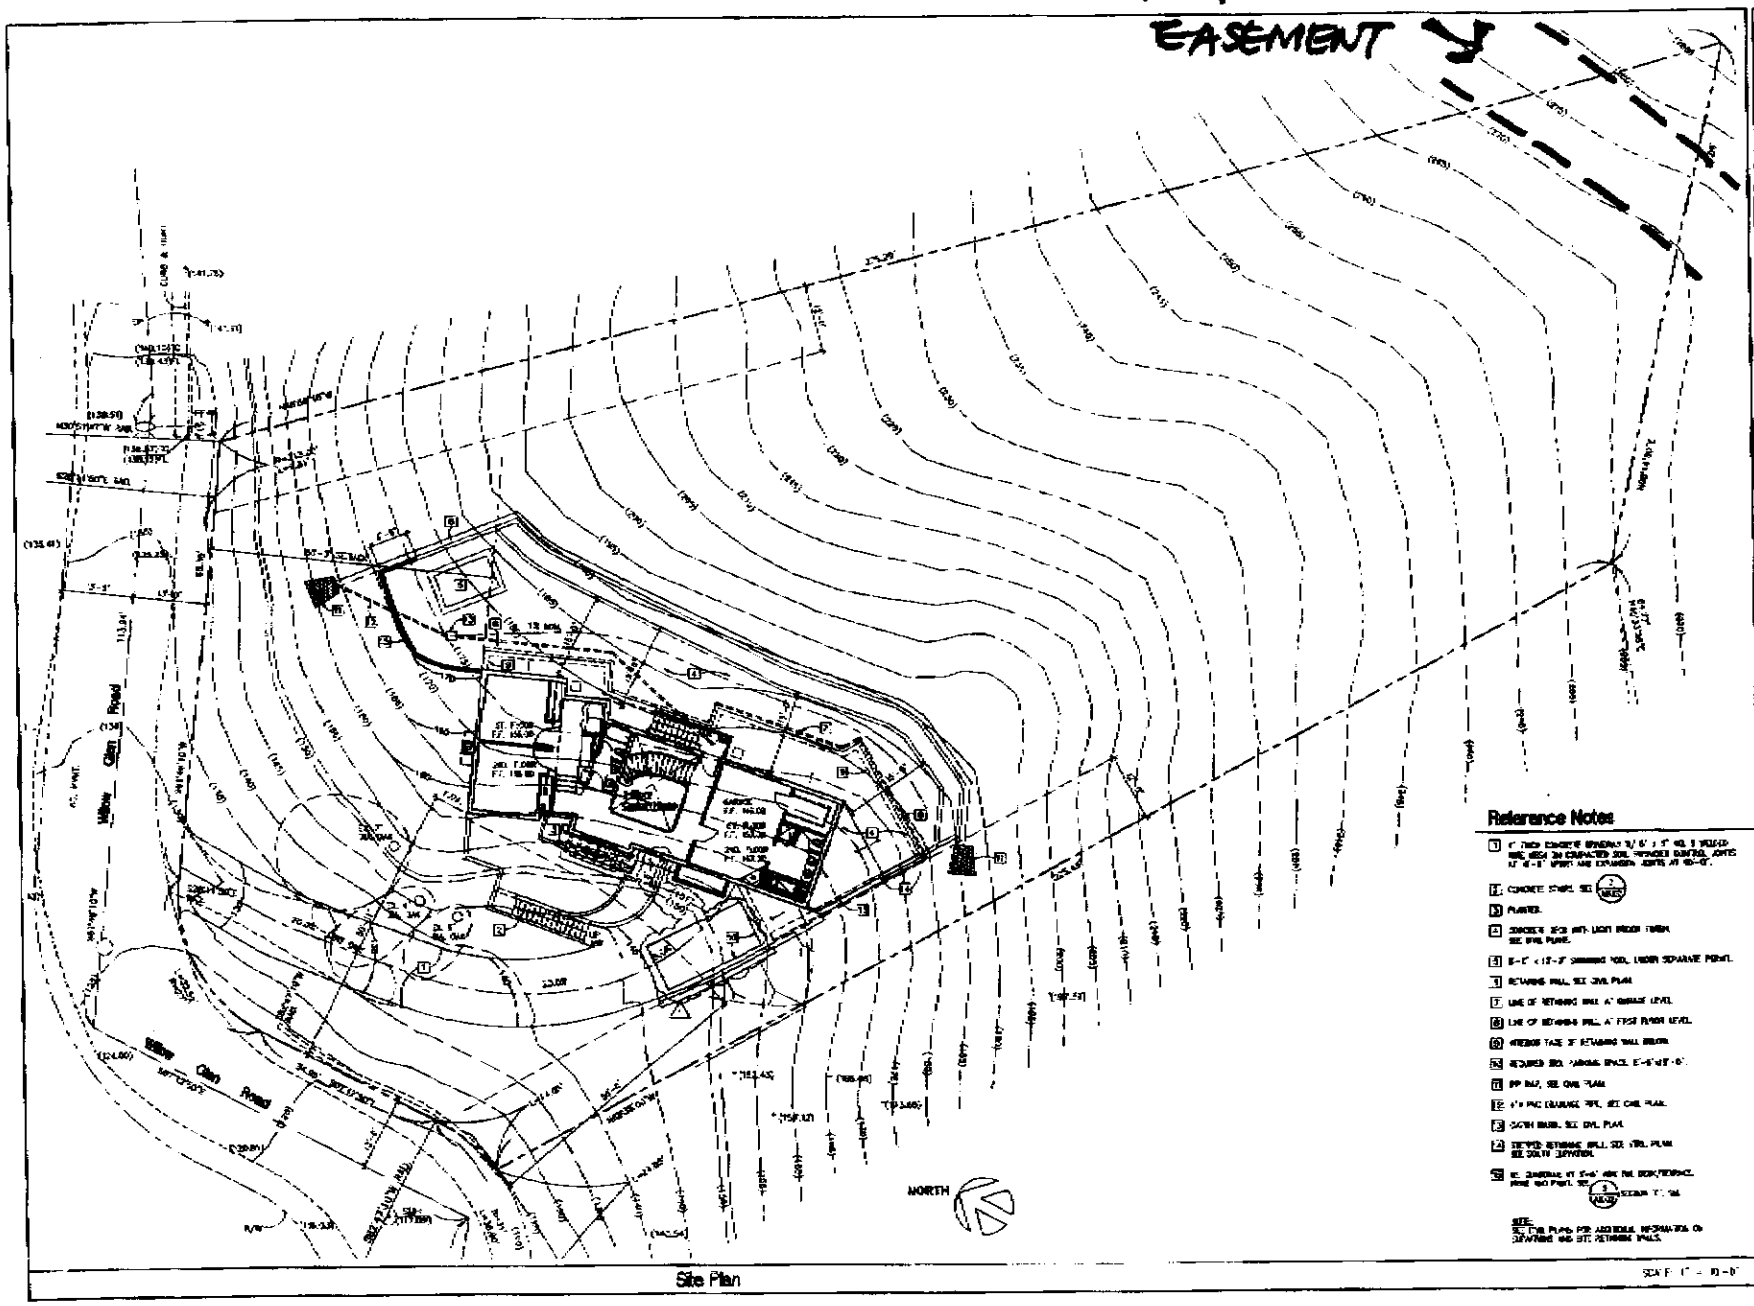

Site Plan

K U S ASSOCIATES, INC.
ARCHITECTS

PROJECT: 2-STORY CUSTOM HOUSE

ADDRESS: 6160 WILLOW GLEN ROAD, LOS ANGELES, CA 90046

CLIENT: MAX CHAFIR
(24 WESTERWOLL DR., #205, WEST HOLLYWOOD, CA 90069)

SHEET TITLE: SITE PLAN

COPYRIGHT © 2010 K U S ASSOCIATES, INC.

JOB NO.
DRAWN BY
SUPERVISED BY: JC
SHEETED BY: AM
PLAN CHECK
PERMIT SET
BID SET

REVISIONS

SHEET NO.: A1.01

OF SHEETS

SHEET